


PIPING & INSTRUMENTATION DIAGRAM — UNIT 3 CRUDE PRE-HEAT TRAIN

CRITICAL SERVICE CORROSION MONITORING LOOP (ASME B31.3 PROCESS PIPING)

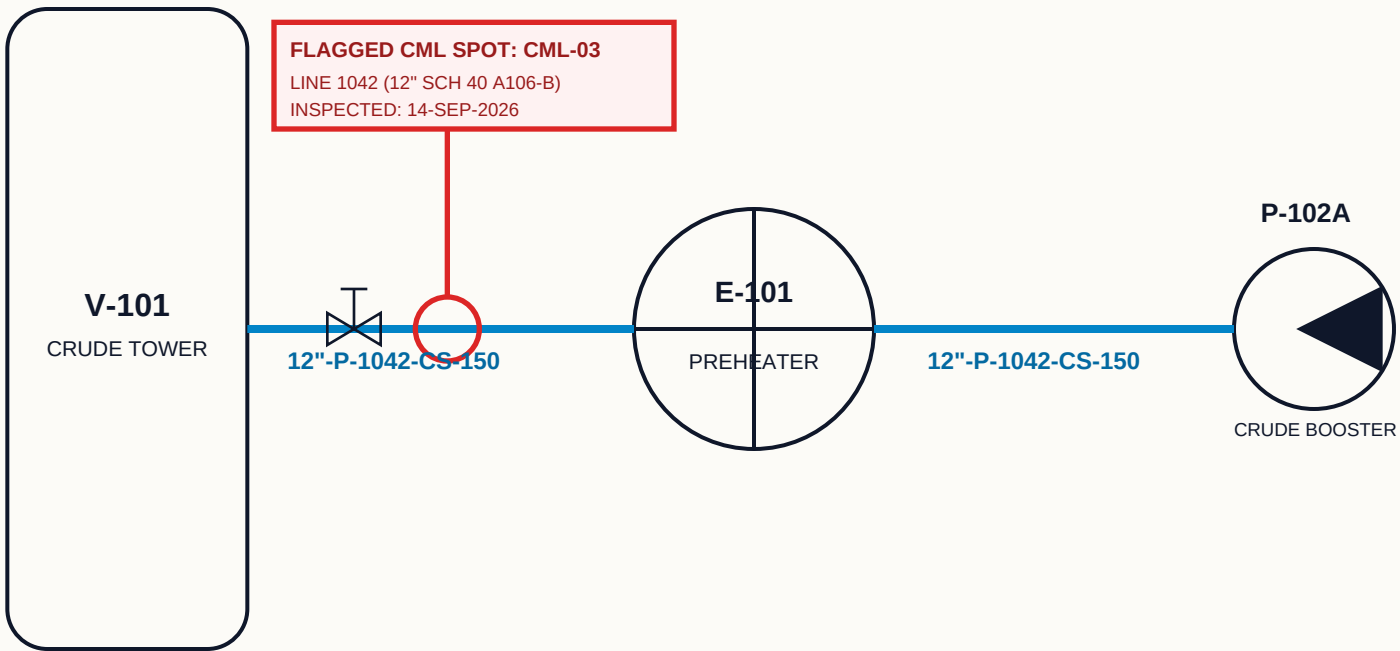

AS-BUILT PLANT SCHEMATIC
 CONTROLLED DOCUMENT // PSU DIVISION
 VERIFIED FOR UT AUDIT — 2026

INDIAN OIL CORPORATION LTD • REFINERY	
DWG: PID-CDU3-1042-REV4	AREA: UNIT 3 PREHEAT
SERVICE: CRUDE CHARGE	DESIGN: 400 PSIG @ 350°F
LINE TAG: 12"-P-1042-CS-150-H	INSPECTION REF: UT-1042